



- MATERIALS**
- FLOOR TRUSSES  
40 \* 40 \* 2.5 MM GAL RHS
  - SKID RAILS  
150 \* 75 \* 5MM DURAGAL CHANNELS
  - SPREADER RAILS BOTTOM SKID  
40 \* 40 \* 2.5 MM GAL RHS
  - FLOOR UPRIGHTS BETWEEN SPREADER AND FLOOR TRUSS CENTRALISED  
3 \* APP 100MM 40 \* 40 \* 2.5 RHS

546 BETWEEN RAILS (586 CENTRE TO CENTRE)  
DISTANCE MAY VARY SLIGHTLY DEPENDENT ON BUILD SIZE 600 CENTRES MAX.  
40 \* 40 \* 2.5 GAL RHS      150 \* 75 \* 5 MM DURAGAL CHANNEL

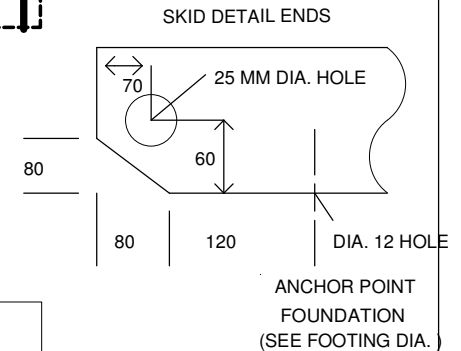

GAL WALL HANG BRACKET FULL PERIMETER  
WELDED TO 40 MM FLOOR SUPPORTS ALL CONTACT POINTS

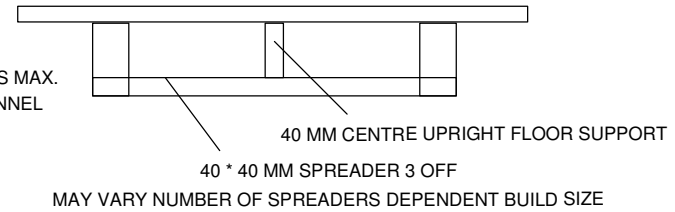

HANGER AROUND BUILDING PERIMETRE 1.6 MM GALVANISED STEEL

<p><b>MANUFACTURER</b> ANOTHER ROOM</p> <p>P.O BOX 647 MORUYA NSW 2537 PH/FAX 02 44 740393 MOBILE 0428 632247</p>	<p>CLIENT:</p>	<p>PROJECT PORTABLE PANEL BUILDINGS</p>			
		<p>TITLE TYPICAL SKID DWG.</p>			
		SCALE N.T.S	DRAWN BY G.L	SHEET OF	DWG No
		DATE	CHCKD GL	JOB No	AS BUILT