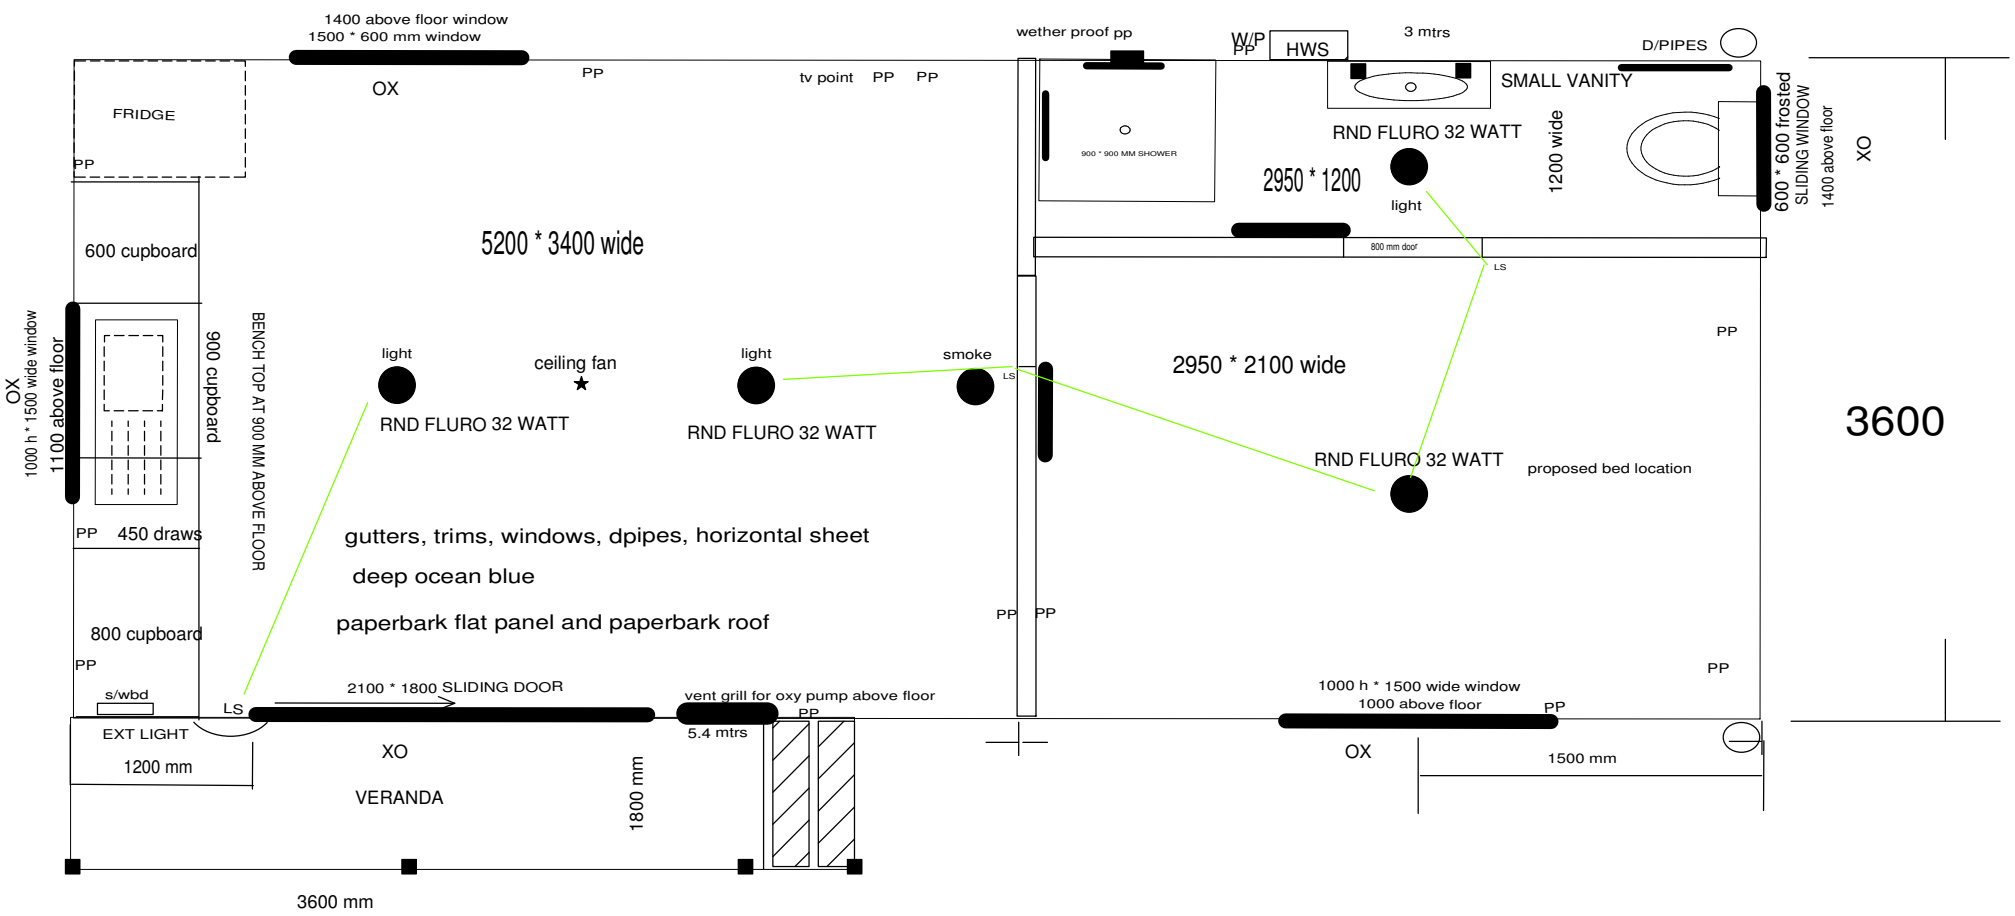

LAMONT TRUST T/AS ANOTHER ROOM

P.O BOX 647 MORUYA NSW 2537

PH/FAX 02 44 740393 MOB 0428 632247

CLIENT:

PROJECT			
TITLE 8.4 mtr * 3.6 mtr grandad flat			
SCALE N.T.S	DRAWN BY G.L	SHEET OF	DWG No
DATE 20/2/11	CHCKD GL	JOB No	AS BUILT